

LAYOUT PLAN

AS-BUILT SURVEY OF
ESTATE PERIMETER WALL AND SEWER LINE
ERF 1693 TO 1705
IN THE TOWNSHIP
PARKRAND EXTENSION 14
SITUATED IN EKURHULENI METROPOLITAN MUNICIPALITY
PROVINCE: GAUTENG
SCALE 1 : 500

X + 2 903 900


X + 2 903 900

X + 2 904 000

X + 2 904 000

X + 2 904 100

X + 2 904 100

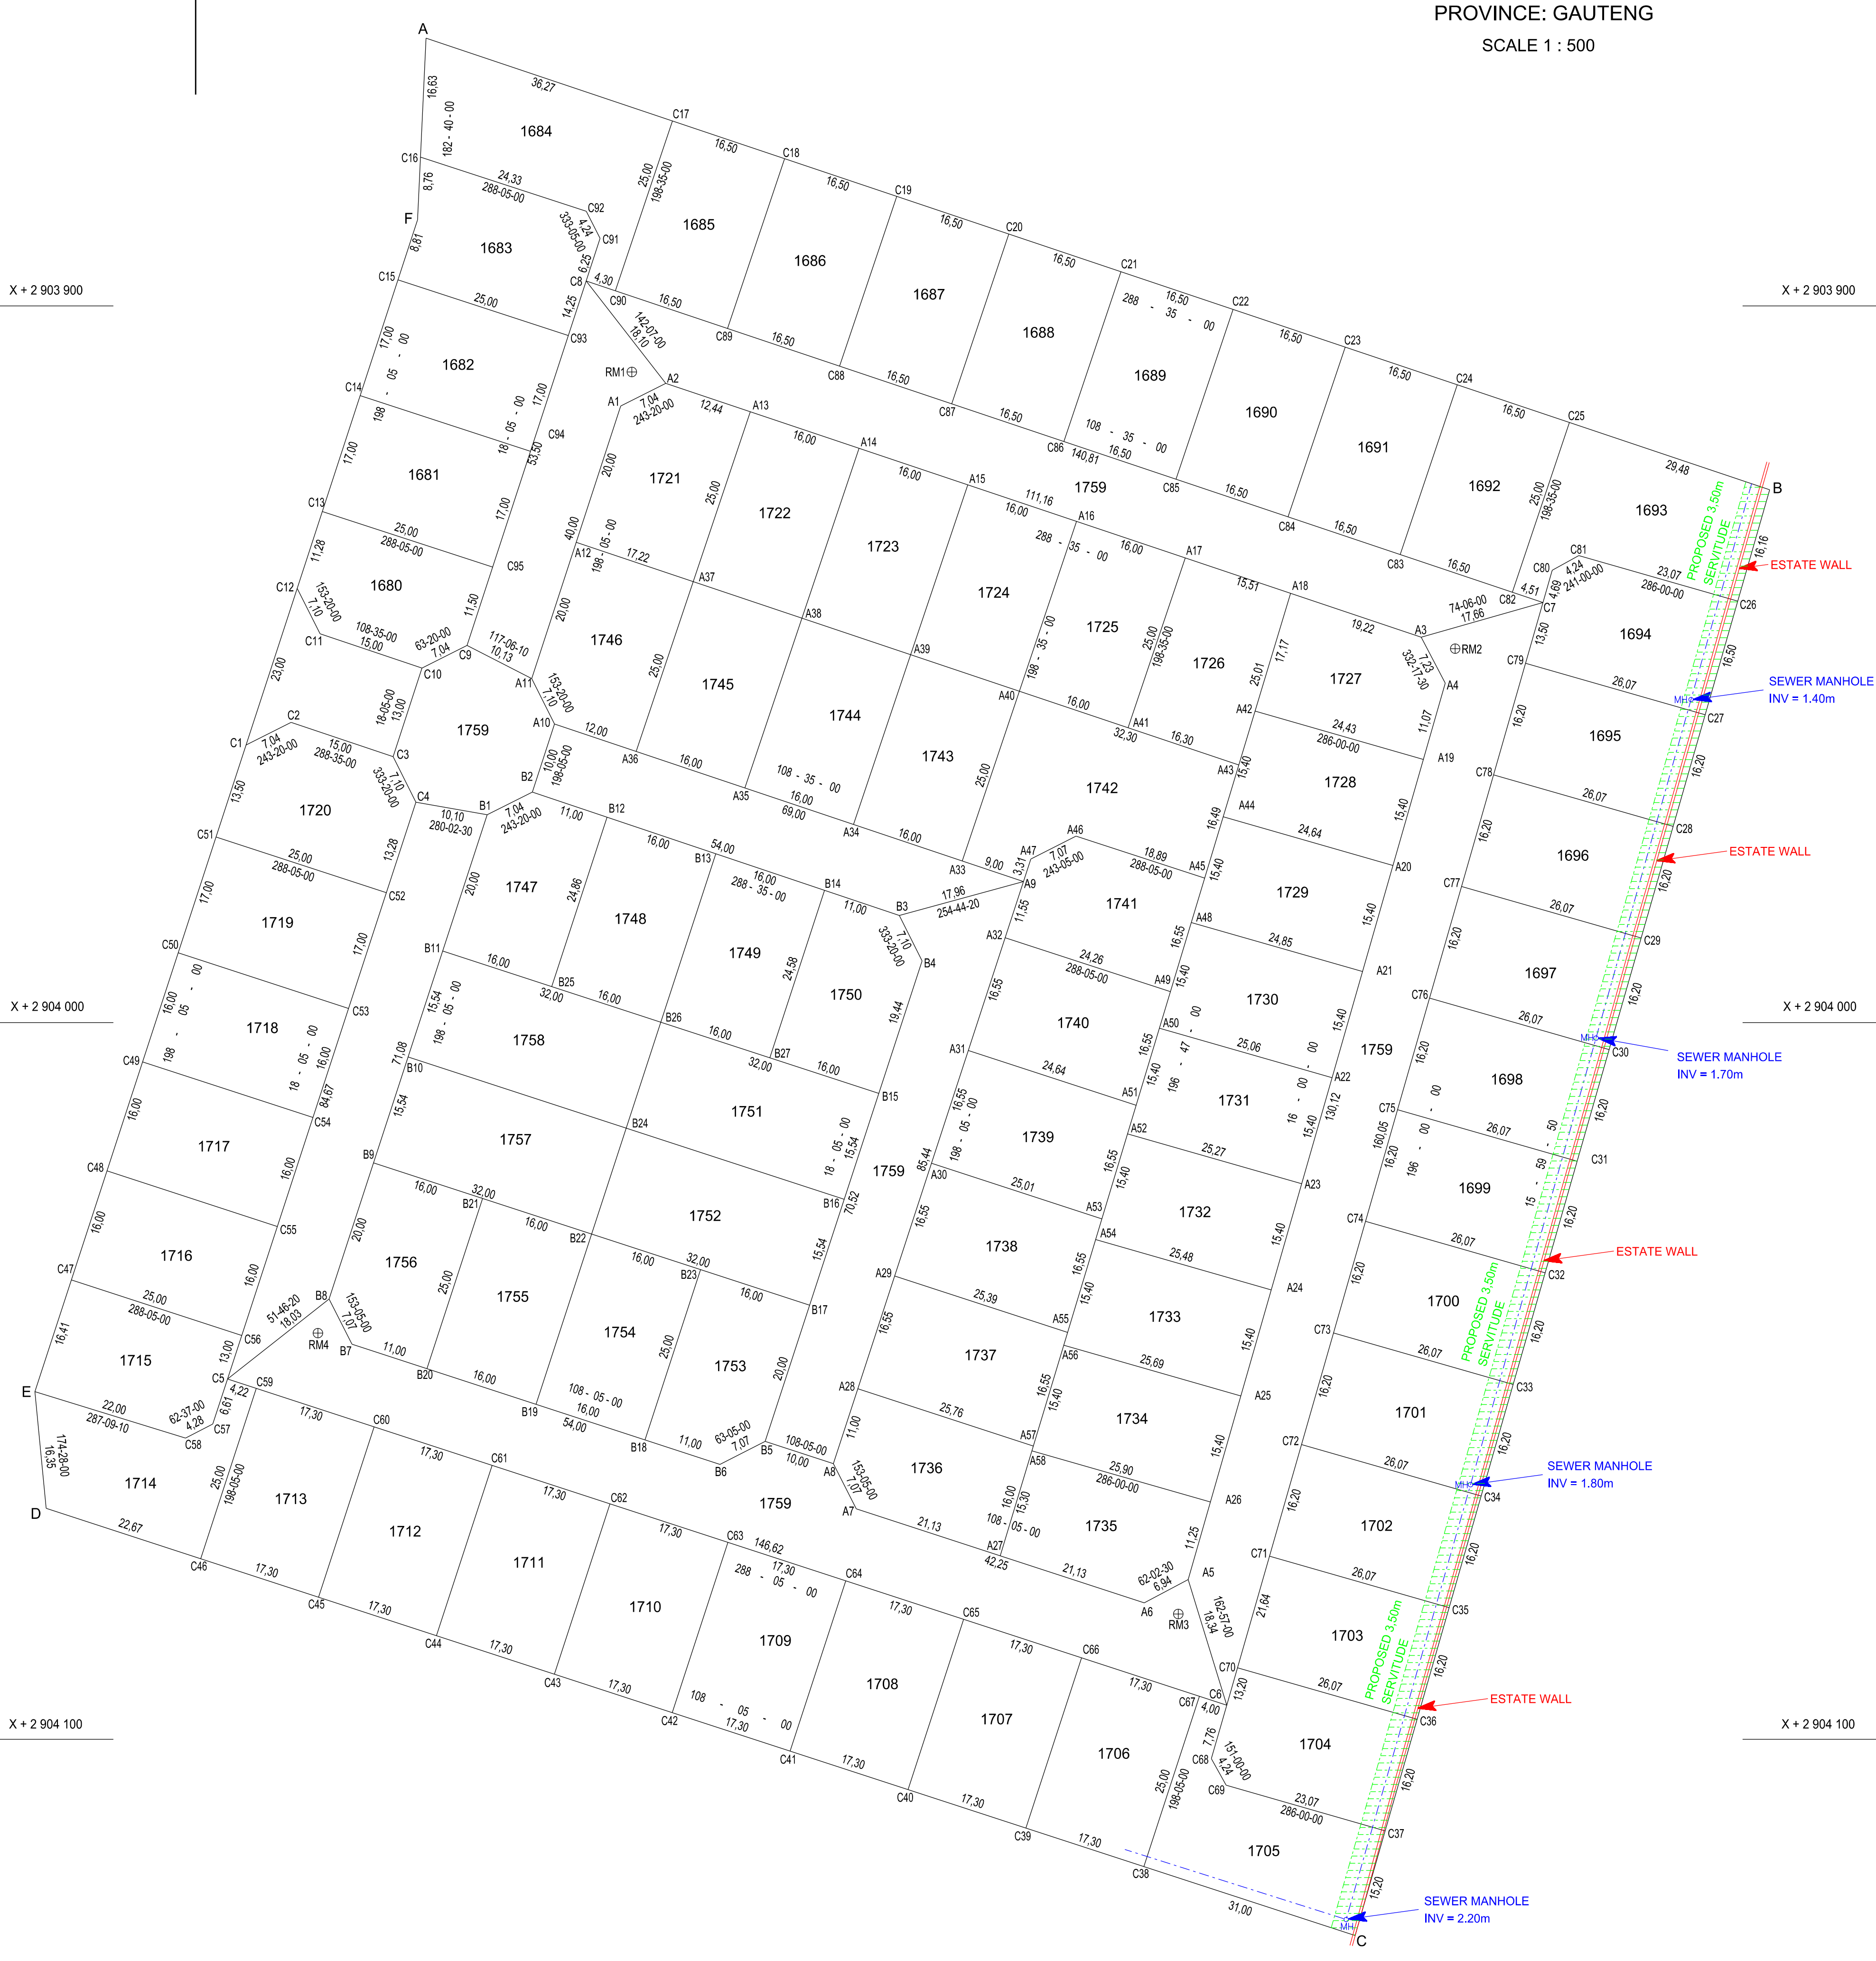

- LEGEND -**
- Inside/Outside Face of Wall - —
 - Manhole - ○ MH
 - Underground Sewer Line - - - -

Y + 70 800

Y + 70 700

Y + 70 800

Y + 70 700